

Case Number: WLS-2003-02619

BUNCOMBE COUNTY HEALTH CENTER
ENVIRONMENTAL HEALTH SERVICES (828-250-5016)
OPERATIONS PERMIT

PIN: 062600996390008


Property Owner: Timothy Miller Property Location: Gold Anchor Lane Application Date: 10-29-03

Directions: Hwy 9 (S) -> (R) on Gold Anchor Lane -> (R) at Fork property on left

Subdivision: NA Phase/section: NA Lot# NA Installer: Edwin Shock

Water Supply: Private Well Spring Shared Well Community Min. Required Separation Distance _____ Installed? Yes No

Conditions: 1) Pump septic tank every 3 to 5 years. 2) Divert all gutters and other surface water, away from septic system and repair areas. (3) No cutting or filling over septic system and repair areas.

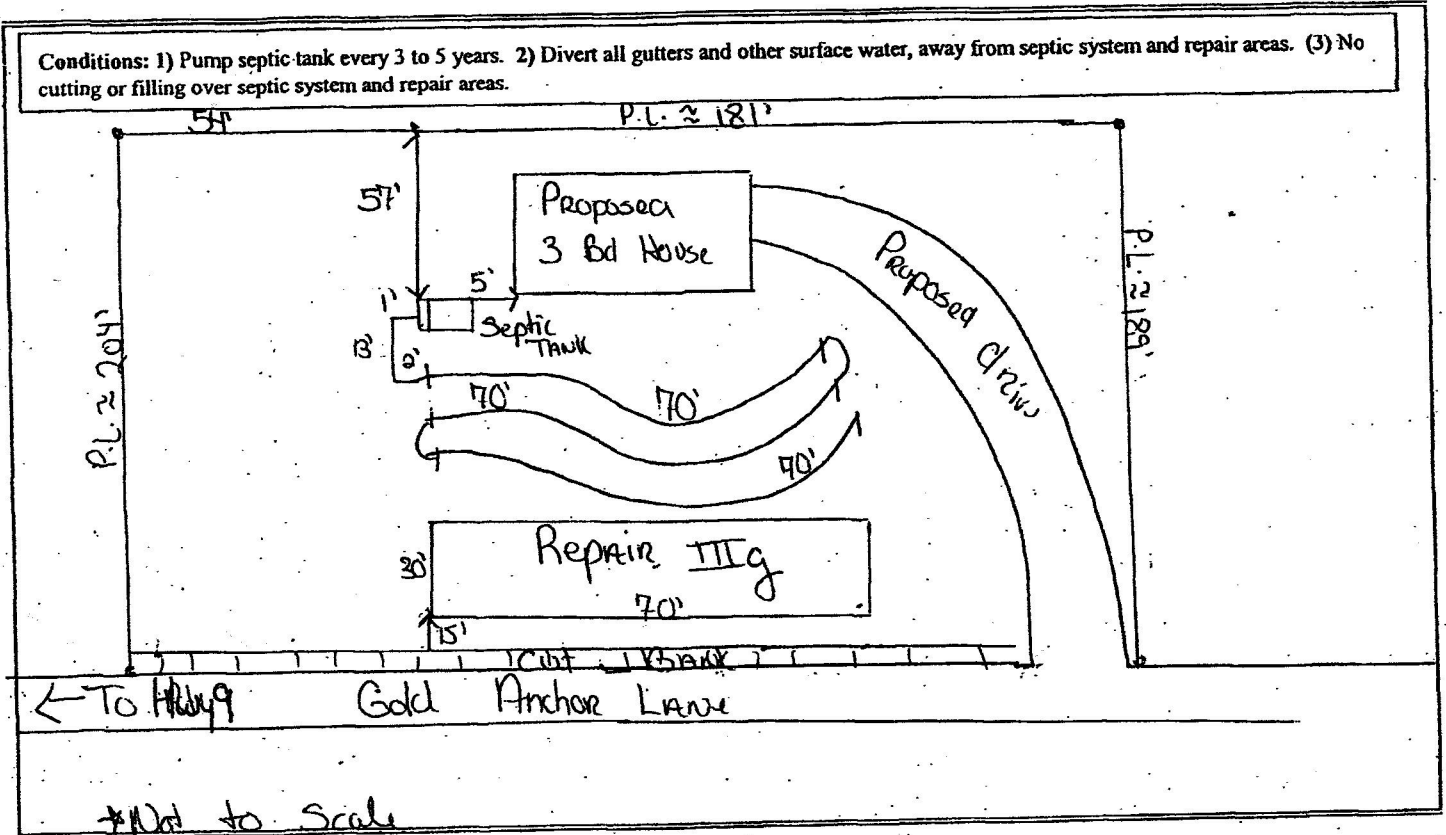

Operations Permit For: New System Repair Revision Drawings, plans, conditions, etc. attached? Yes No

System Approved For: House Mobile Home (single double) Bedrooms: 3 Basement: Yes No Basement Plumbing: Yes No

Multiple Unit Dwelling: No. of Units _____ Number of Bedrooms per unit _____ Business No. Employees: _____ No. Shifts: _____

Operation Description: _____ Industrial Waste: Yes No

Approved Installation Specifications: Total Design Flow: 360 LPM 45 GPD System Classification: Type I, II, III, IV, V, VI

Pump System Required: Yes No Pump Specification: Pump Make: _____ Model: _____ Serial No. 0

Trenches: Length: 210 ft No. of Trenches: 3 Width: 36 Spacing: 9 ft Depth: 24-30 in (lower sidewall) Stone Depth: N/A in

Distribution: Equal Gravity Pressure Manifold Serial Dams/Step Downs Tank Size: Septic: 1000 (gallons) Pump Tank: N/A (gallons)

System Description: Prefabricated Panel Block Conventional Large Diameter Pipe Chamber Expanded Polystyrene Aggregate Other _____

Comments: _____

Inspected by: Felissa M. V... Date: 10-21-04 Issued To: Edwin Shock Date: 10-27-04

The system has been installed in accordance with state sewage rules. Approval does not guarantee the system will function satisfactory for any given time.